


REFERENCES	
NO.	TITLE
1	
2	
3	
4	
5	
6	
7	
8	

REVISIONS			
NO.	DESCRIPTION	DATE	BY
A	ISSUED FOR CONSTRUCTION	11/22	
B	AS BUILT		

ITEM	DESCRIPTION	SPEC	QTY	UNIT
BILL OF MATERIAL				
1080 WALSHIRE BLVD. SUITE 1100 LOS ANGELES, CA, U.S.A.				
TITLE <b>11 METER BUOY HULL COMPOSITE</b>				
CLIENT <b>CPC SRI LANKA</b>				
PROJECT <b>SRI LANKA</b>				
DIMENSION TOLERANCES				
DO NOT SCALE DRAWING DRAWN: [Signature] 9/19/00 CHECKED: [Signature] APPROVED: [Signature] 11/22/00				
SCALE 1" = 1'-0" 2" = 1'-0"				
DWG. NO. 1191-000 SHEET 1 OF 3				

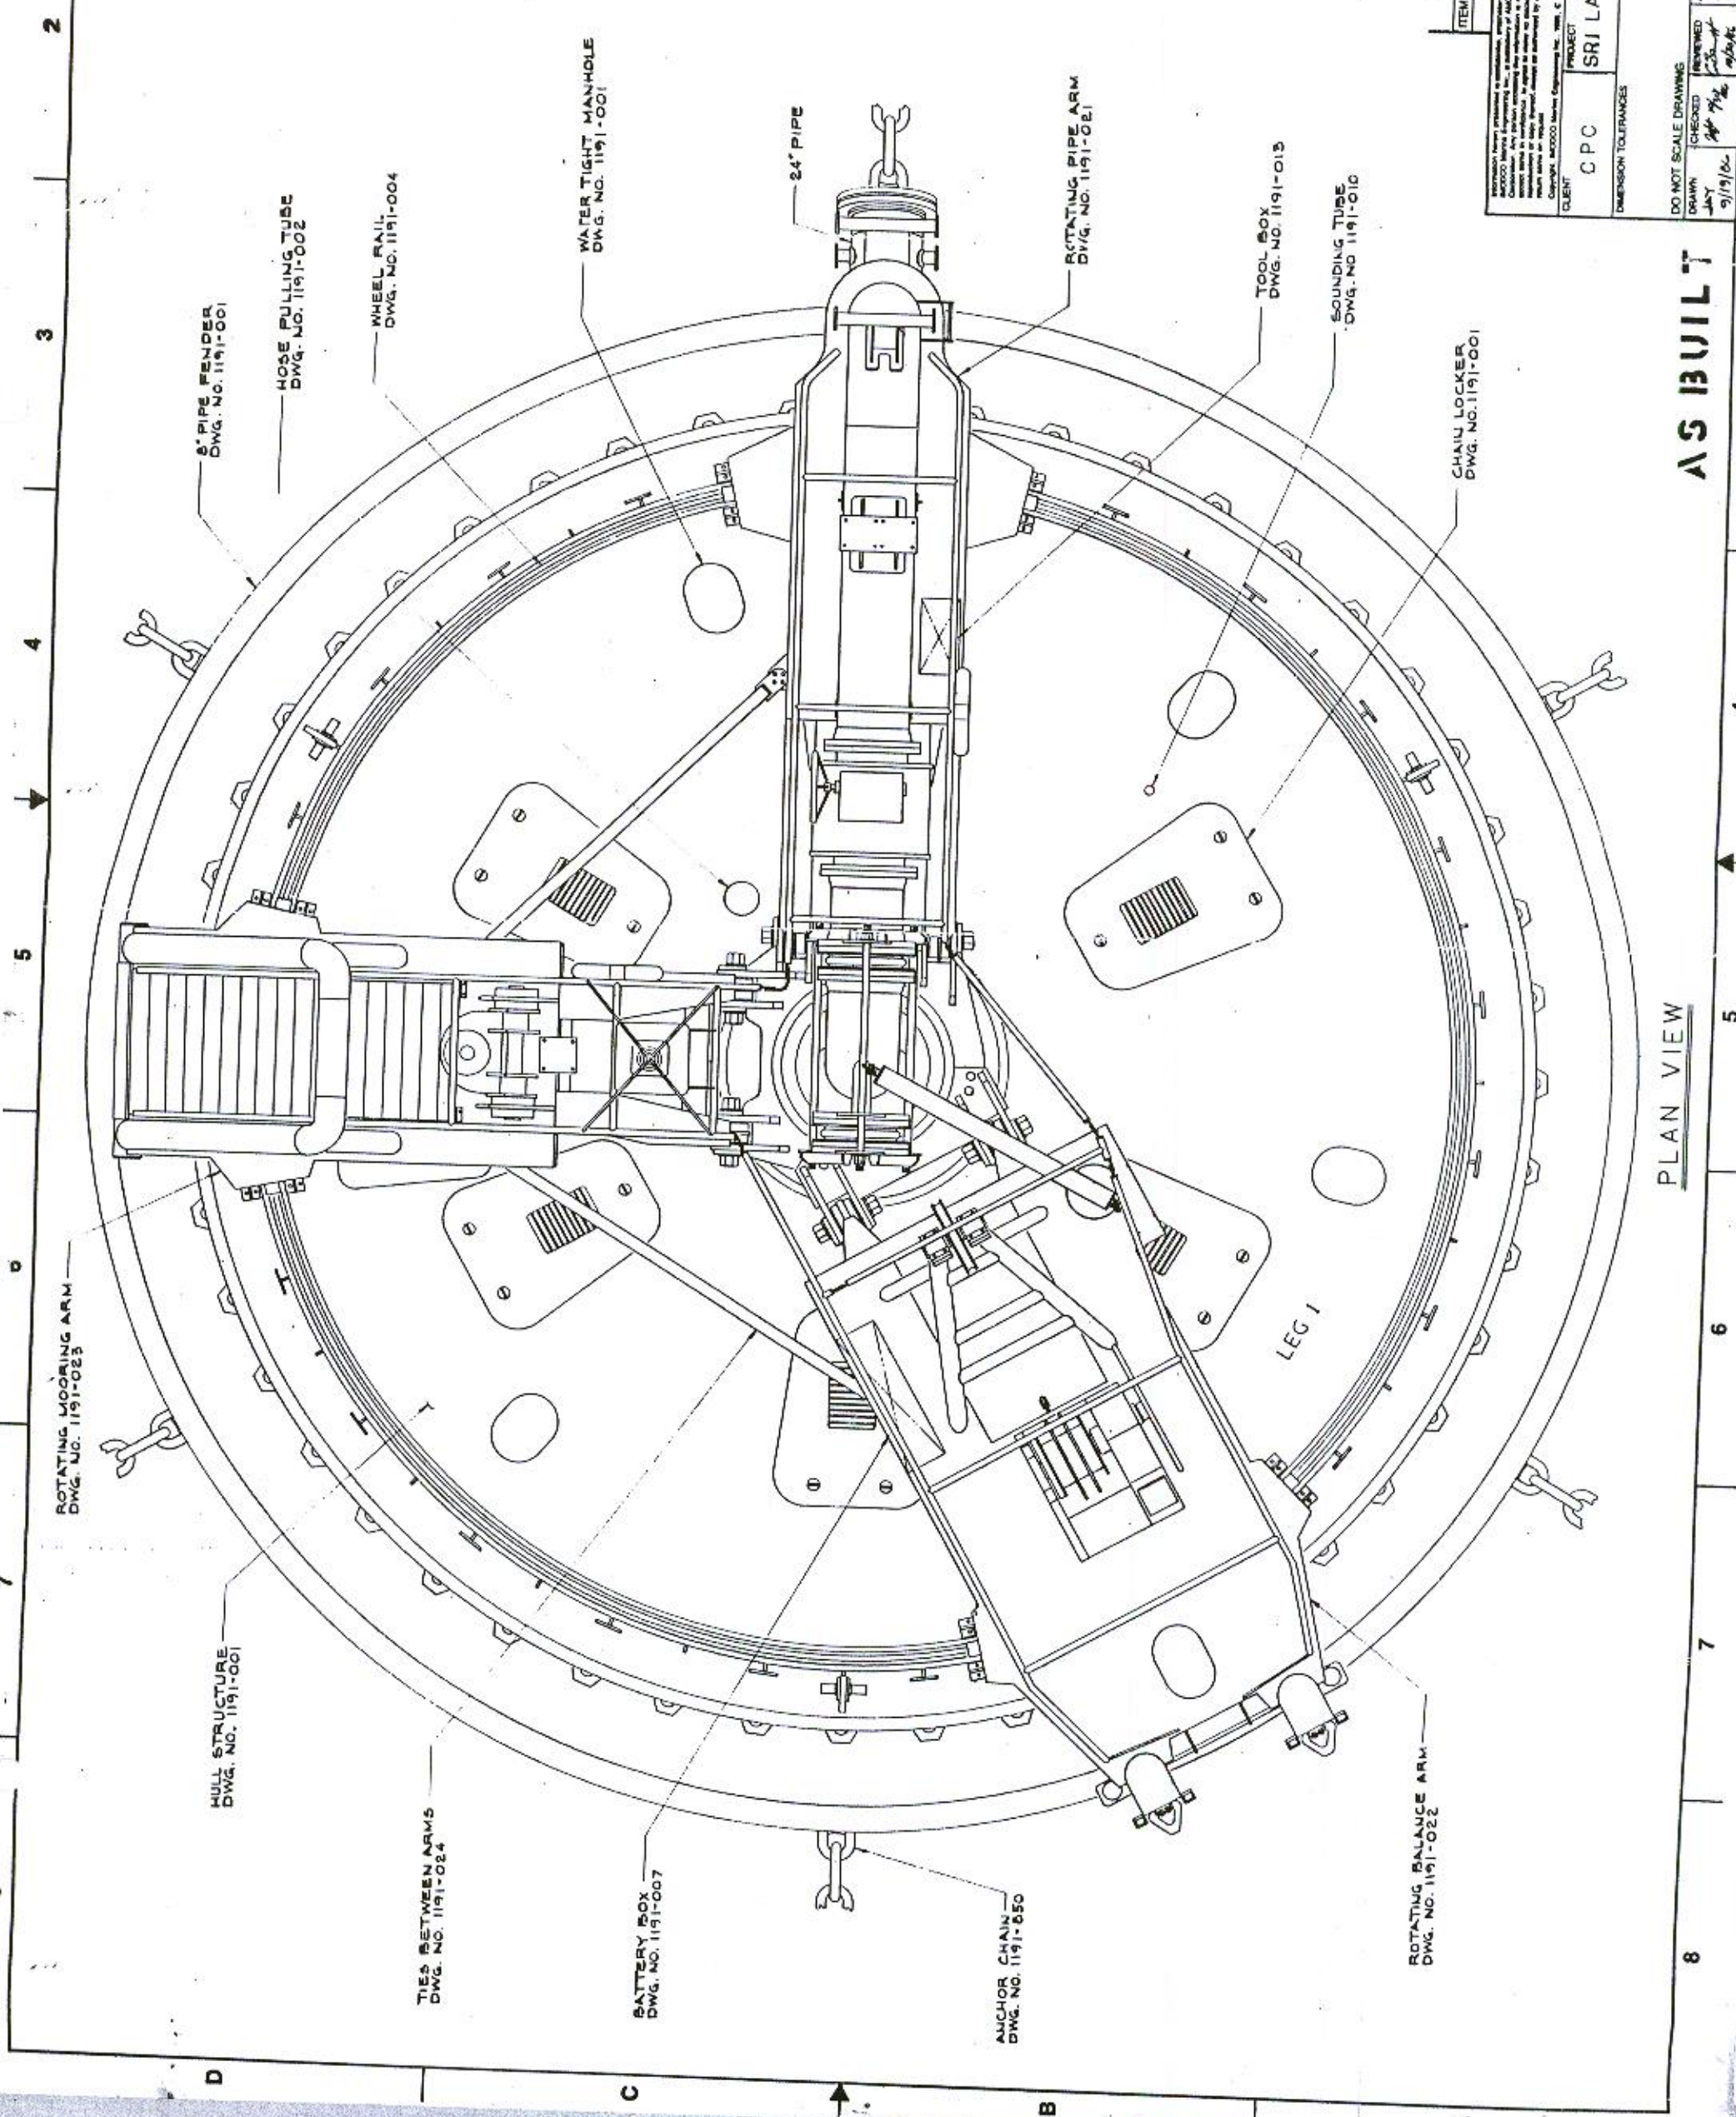

**AS BUILT**

PLAN VIEW

1 2 3 4 5 6 7 8

A B C D