


1 2 3 4 5 6 7 8

REFERENCES	
NO.	TITLE
1	
2	
3	
4	
5	
6	
7	
8	

REVISIONS				
NO.	DESCRIPTION	DATE	BY	APP'D
A	ISSUED FOR CONSTRUCTION	11/19/86	AS	AS
B	AS BUILT			

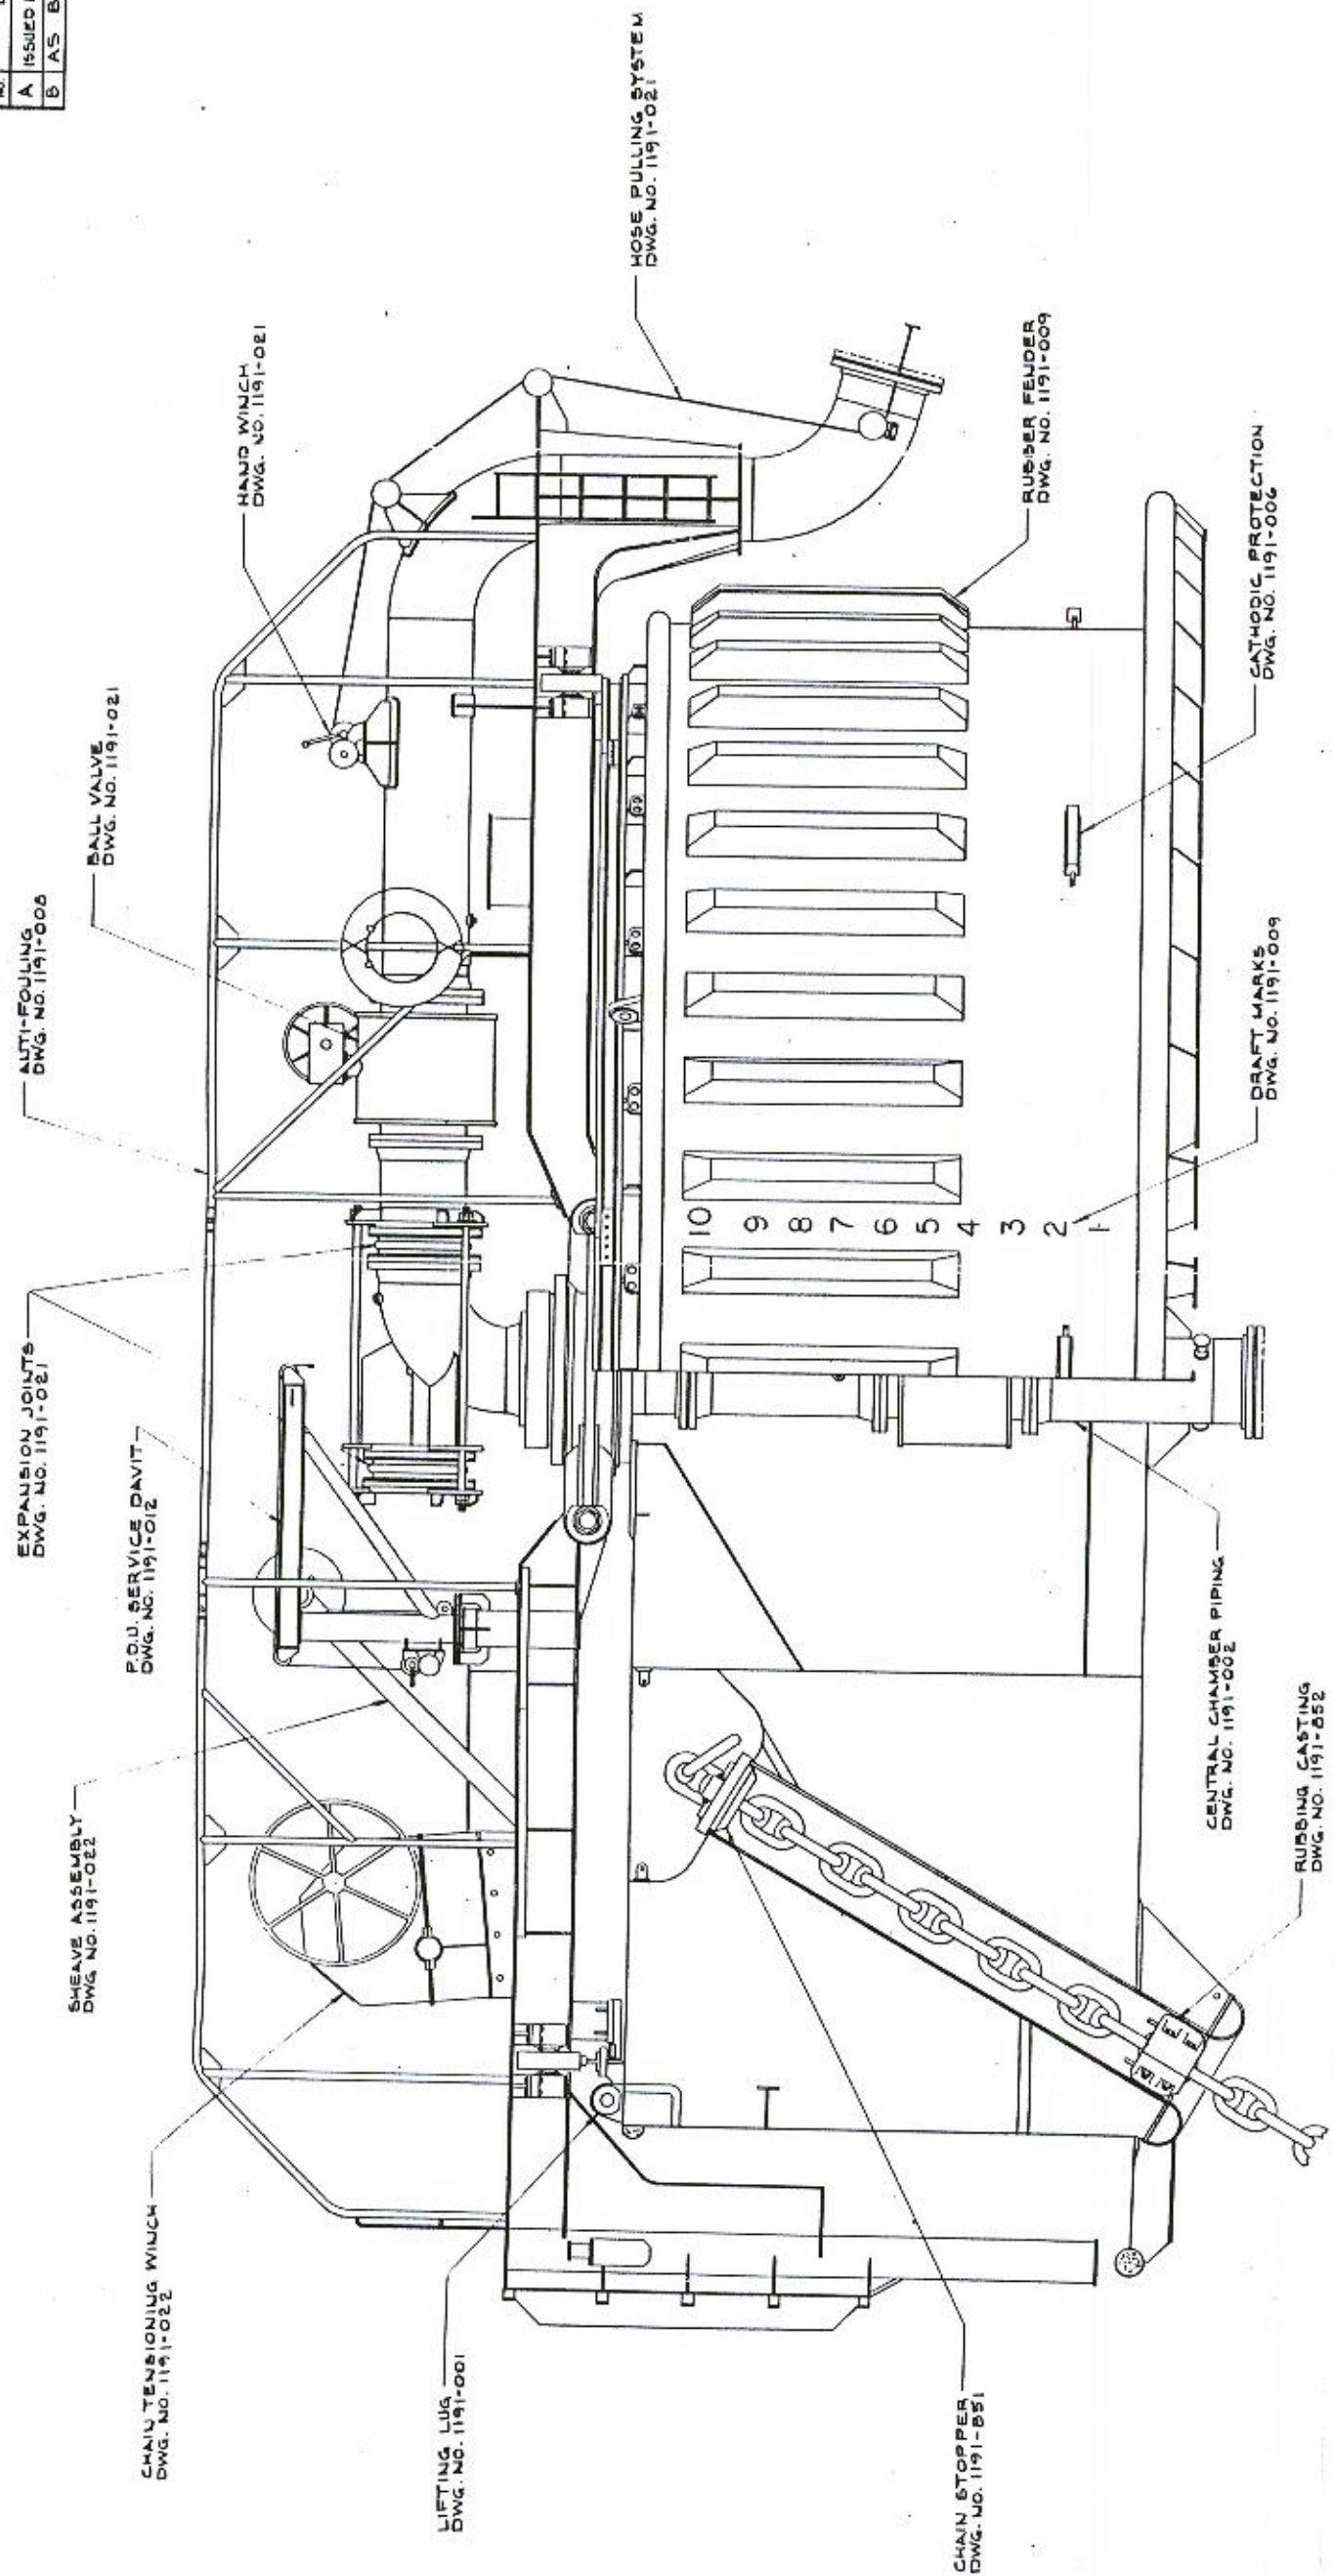

**ELEVATION AT BALANCE & PIPE ARM**

ITEM	DESCRIPTION	SPEC	QTY	SHT
BILL OF MATERIAL				
<b>IMODOCO</b> 1080 WILSHIRE BLVD. SUITE 1100 LOS ANGELES, CA, U.S.A. INTERNATIONAL 8001				
TITLE <b>11 METER BUOY                  HULL COMPOSITE</b>				
CLIENT CPC SRI LANKA				
PROJECT DIMENSION TOLERANCES				
DO NOT SCALE DRAWING DRAWN JULY 9/19/86 CHECKED AS 11/19/86 REVIEWED AS 11/19/86 APPROVED AS 11/19/86				
SCALE 1" = 1'-0" DWG NO. 1191-000 SHEET 2 OF 3				

**AS BUILT**

1 2 3 4 5 6 7 8