


8 7 6 5 4 3 2 1

REFERENCES			
NO.	TITLE	DRAWING NO.	
1			
2			
3			
4			
5			
6			
REVISIONS			
NO.	DESCRIPTION	DATE	BY
A	ISSUED FOR CONSTRUCTION	1/11/80	HA
B	AS BUILT	1/19/80	HA

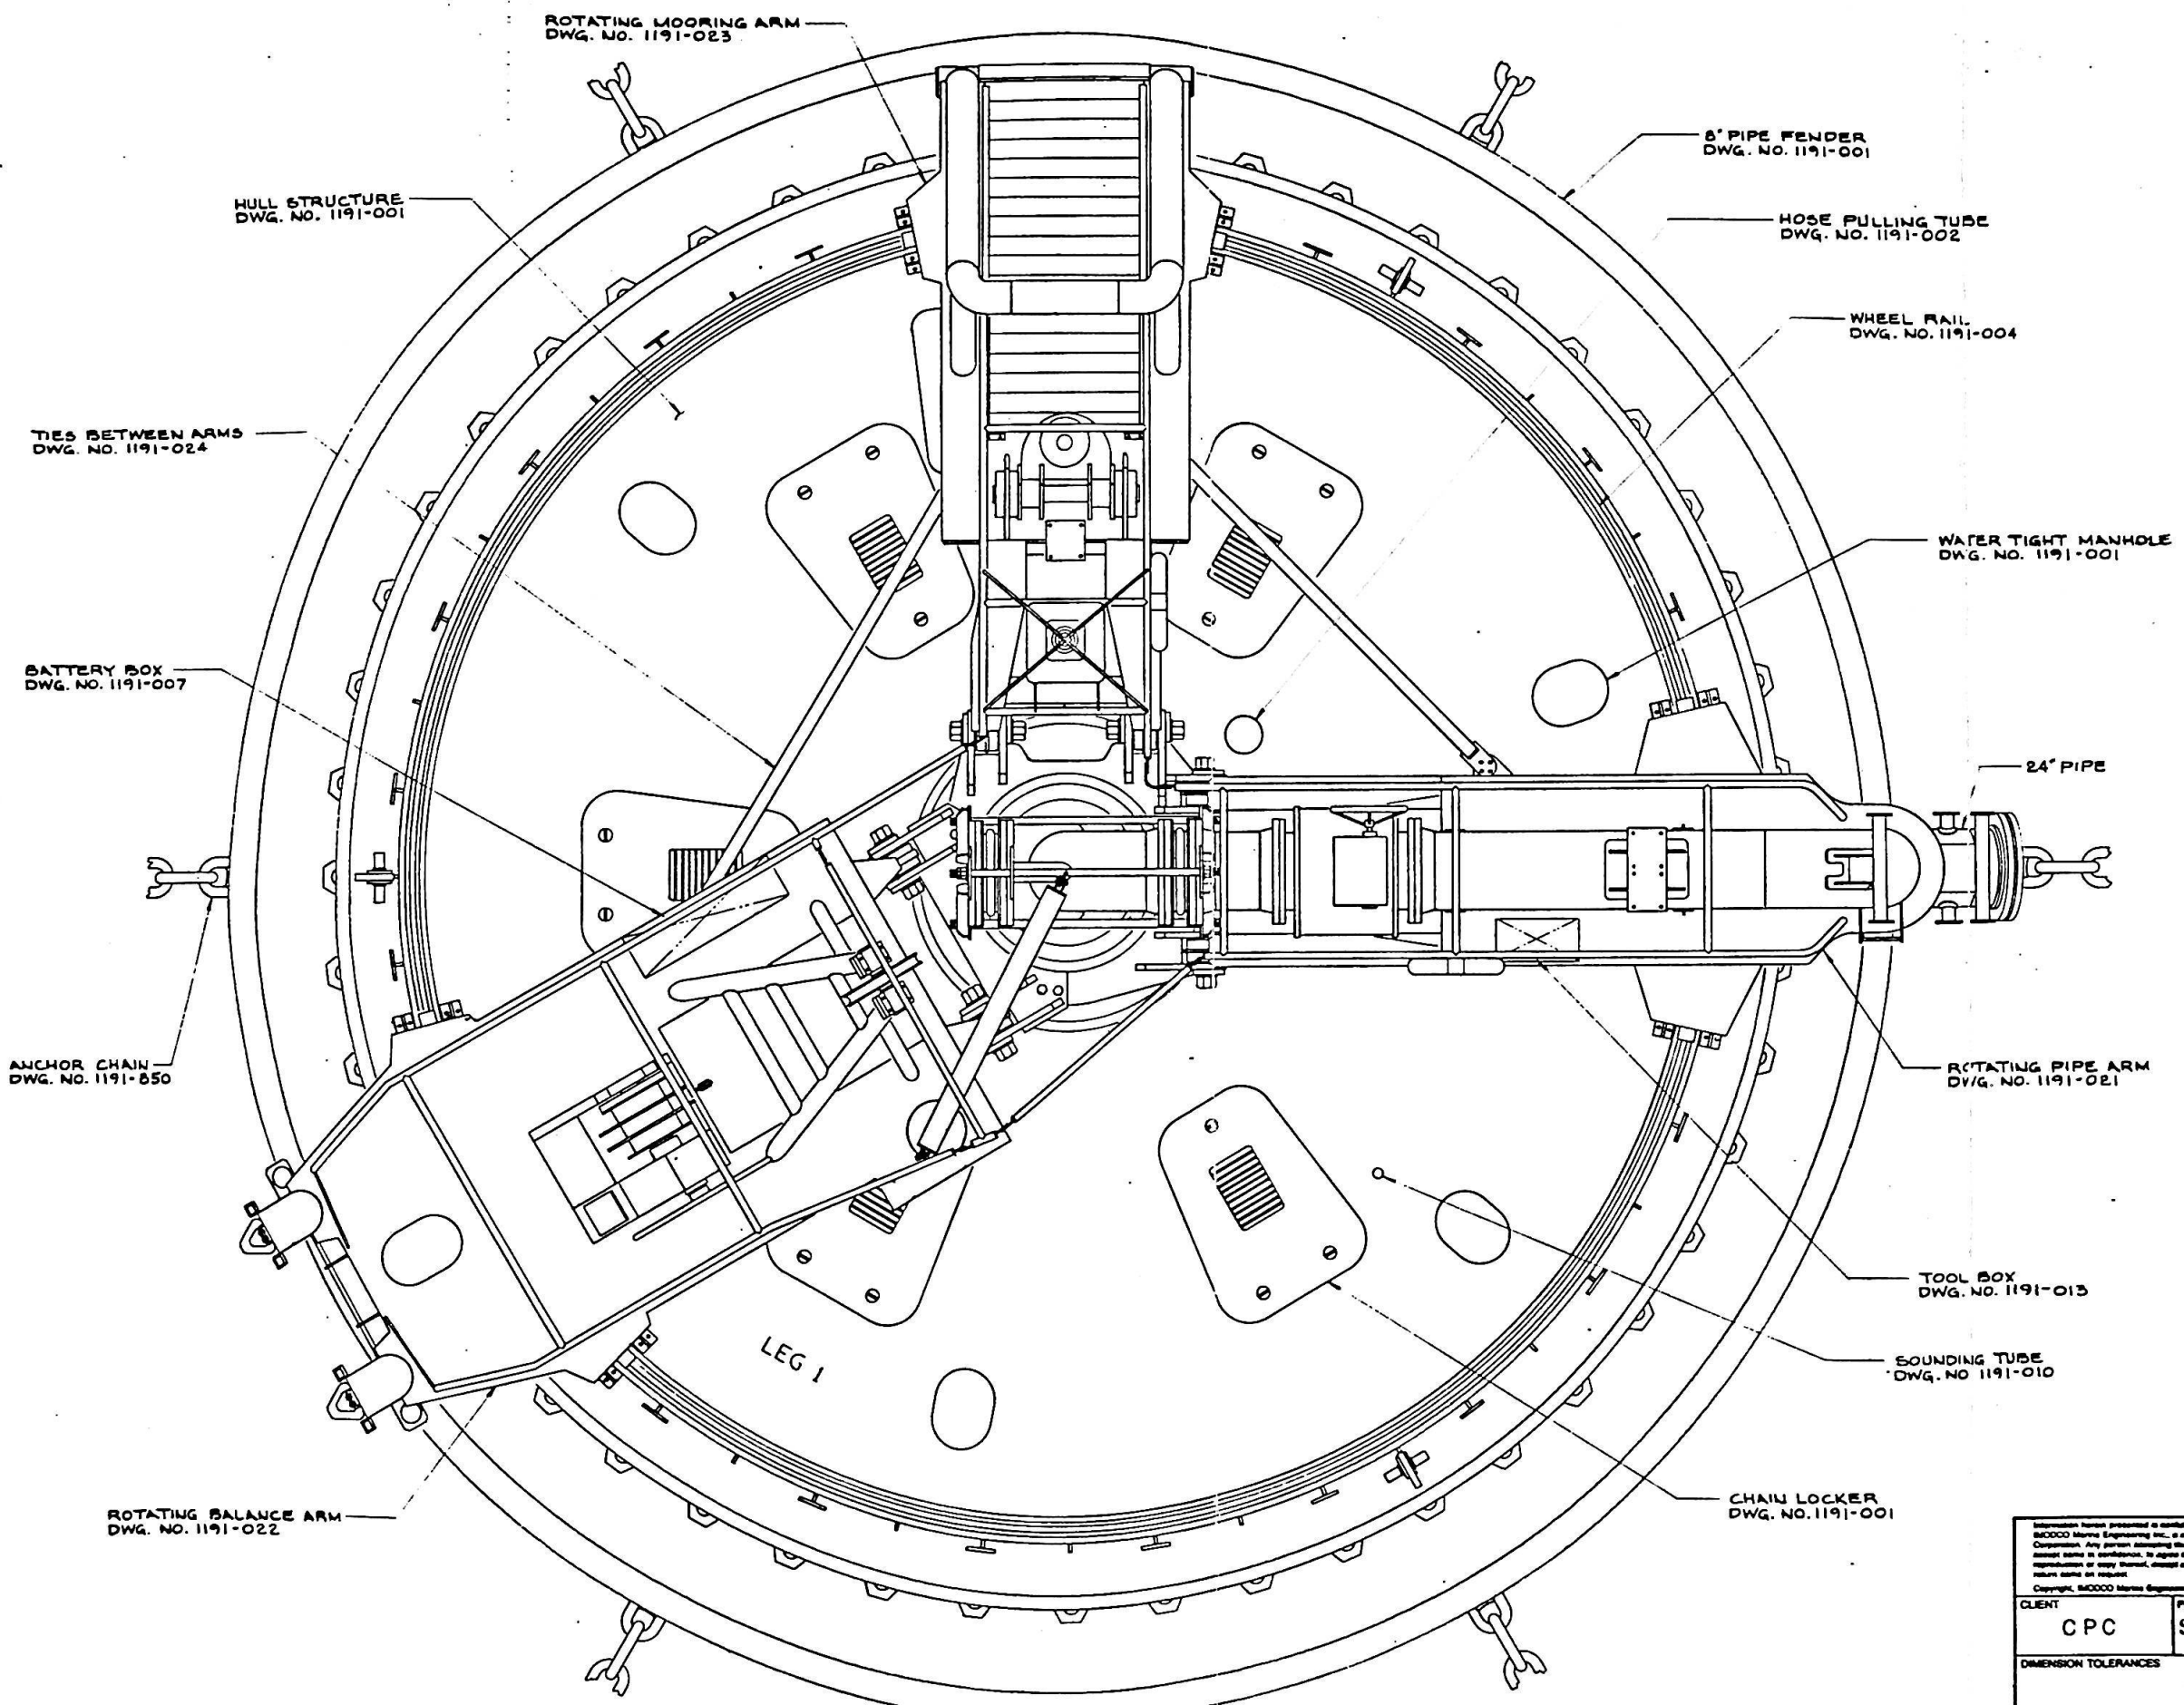

PLAN VIEW


AS BUILT

ITEM	DESCRIPTION	SPEC	QTY	SHT
BILL OF MATERIAL				
<small>Information herein presented is confidential, proprietary information of IMODCO Marine Engineering Inc., a subsidiary of AMCA International Corporation. Any person accepting the information is required to accept same in confidence, to agree to make no disclosure, use, reproduction or copy thereof, direct or indirect, by AMCA, and to return same on request.</small>				
<small>Copyright, IMODCO Marine Engineering Inc., 1988, ©</small>				
CLIENT	CPC	PROJECT	SRI LANKA	TITLE
DIMENSION TOLERANCES				IMODCO AMCA INTERNATIONAL 1080 WILSHIRE BLVD., SUITE 1100, LOS ANGELES, CA, U.S.A. 90024
DO NOT SCALE DRAWING				12 METER BUOY HULL COMPOSITE
DRAWN	CHECKED	REVIEWED	APPROVED	SCALE
JAY	1/19/80	1/19/80	1/19/80	1\"/>
DWG. NO. 1191-000				SHEET 1 OF 3

D  
C  
B  
A

D  
C  
B  
A

8 7 6 5 4 3 2 1

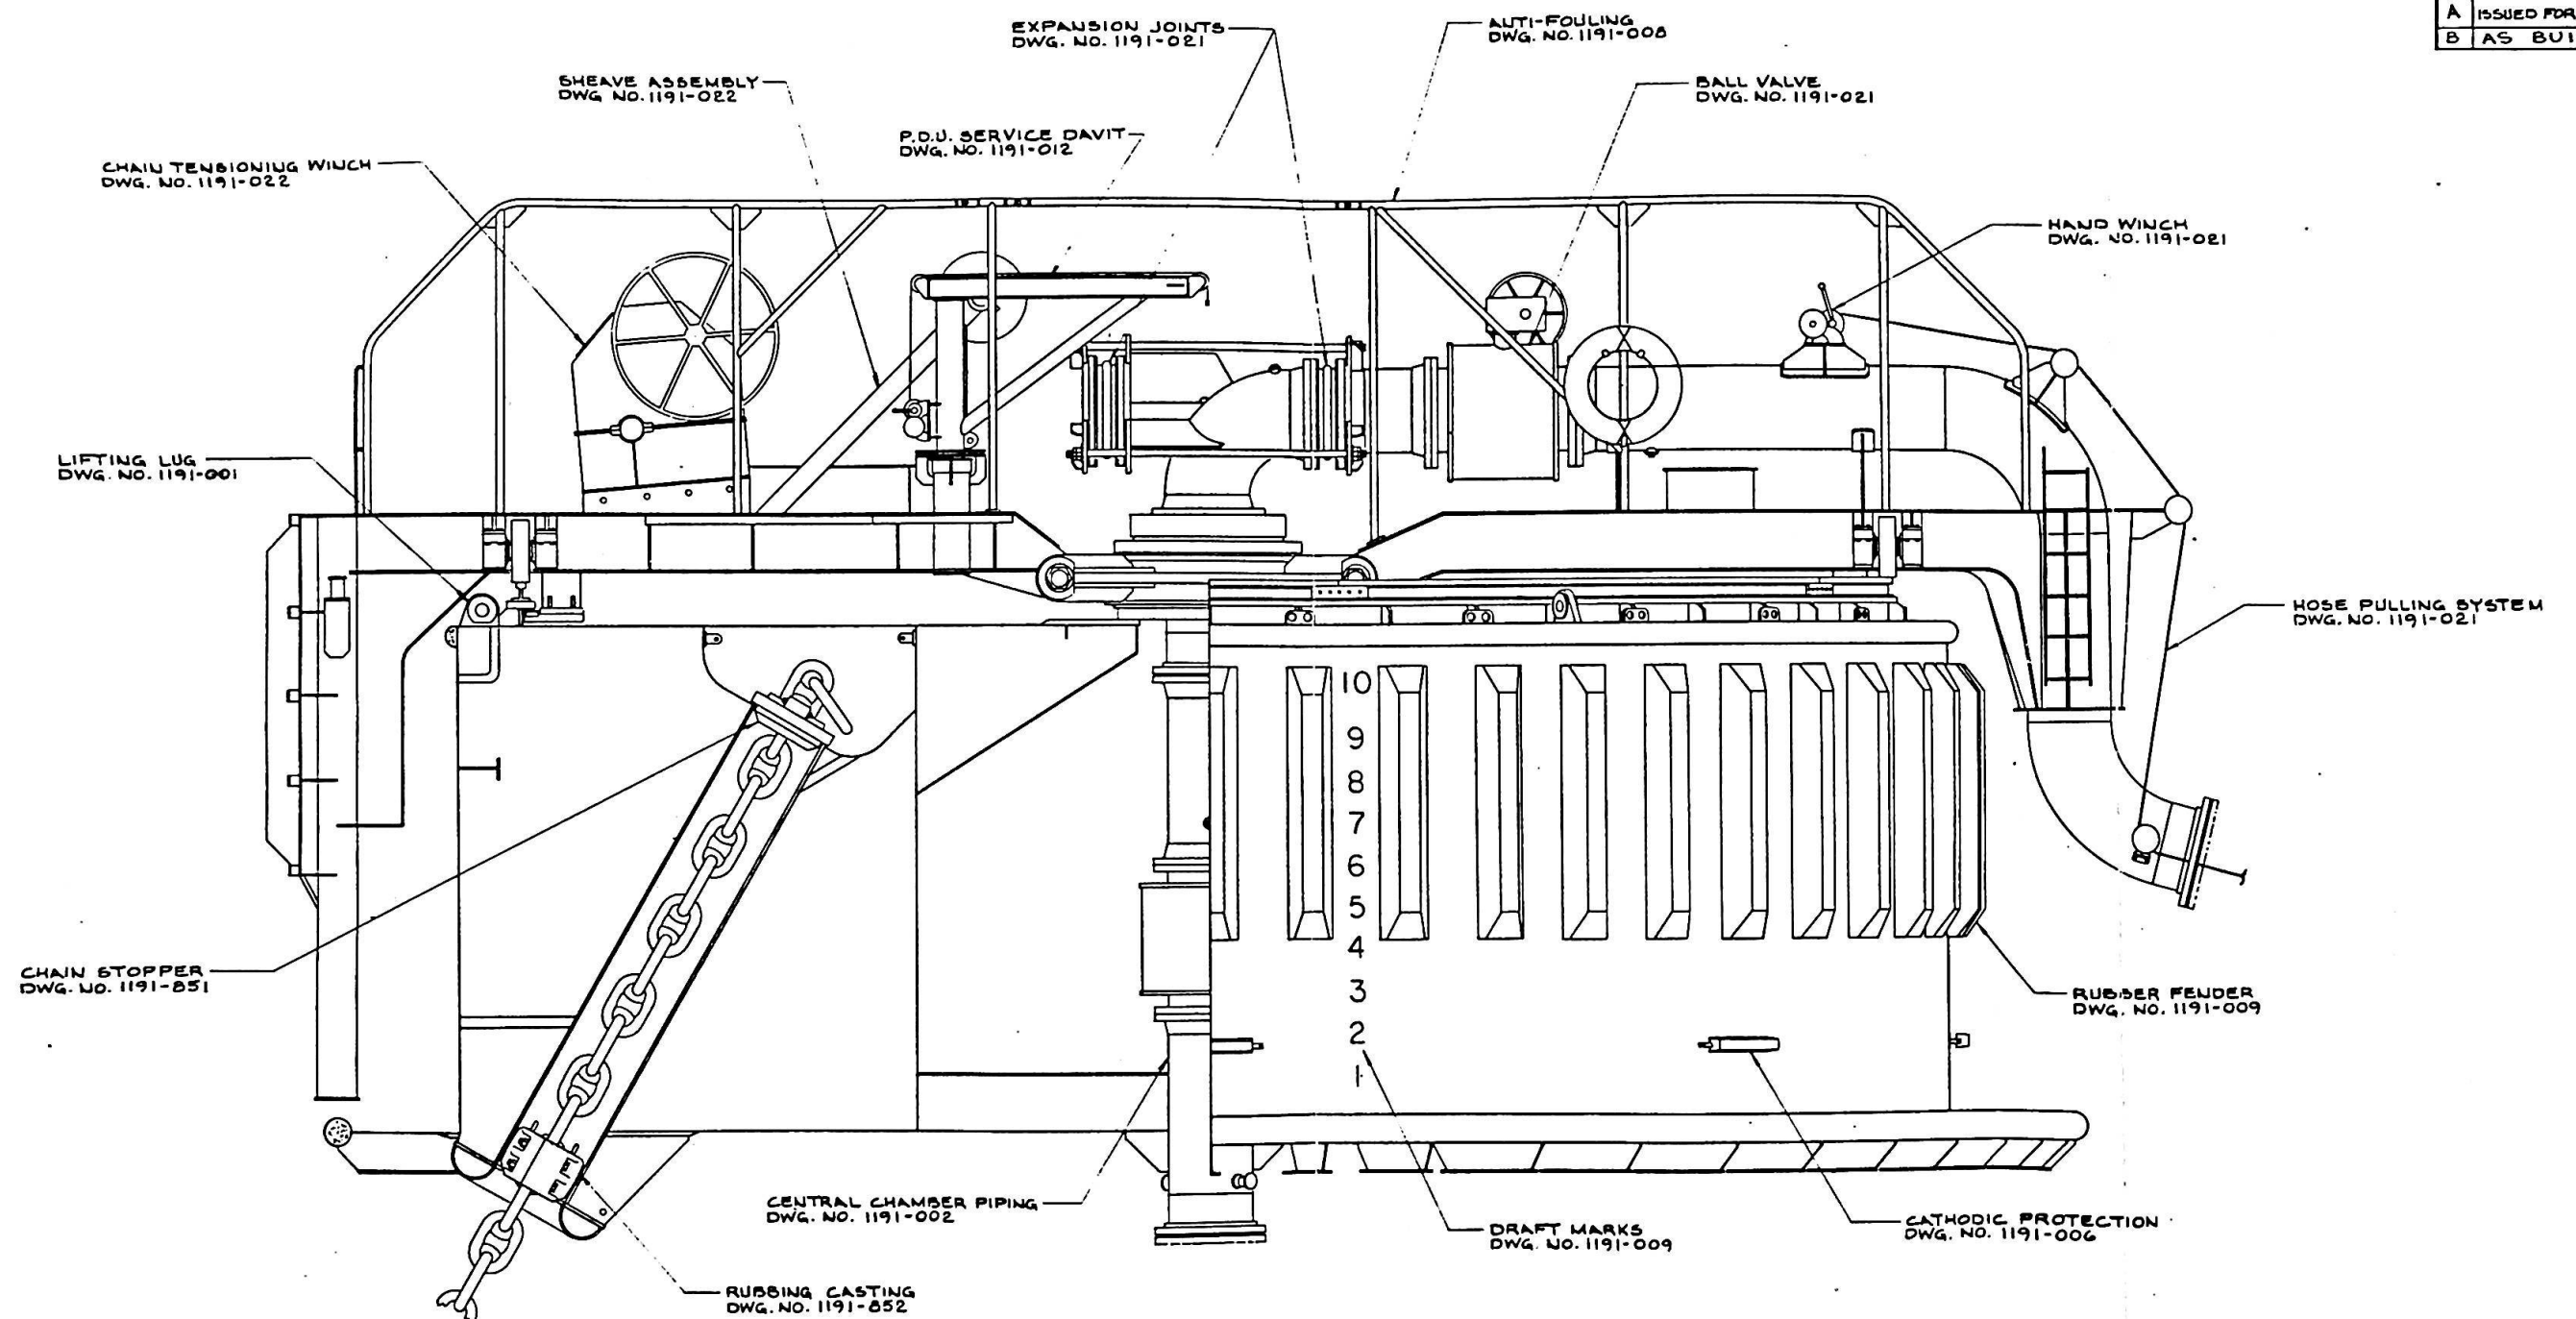

ELEVATION AT BALANCE & PIPE ARM

AS BUILT

REFERENCES			
NO.	TITLE	DRAWING NO.	
1			
2			
3			
4			
5			
6			

REVISIONS				
NO.	DESCRIPTION	DATE	BY	APPD.
A	ISSUED FOR CONSTRUCTION	1/1/86	AS	AS
B	AS BUILT	1/1/86	AS	AS

ITEM	DESCRIPTION	SPEC	QTY	SHT
BILL OF MATERIAL				
INFORMATION HEREIN IS UNCLASSIFIED, PROPRIETARY INFORMATION OF IMODCO Marine Engineering Inc., a subsidiary of AMCA International Corporation. Any person receiving this information is required to keep it confidential, to agree to keep it confidential, and to reproduce it only as authorized by IMCA, and to return it upon request.		IMODCO AMCA INTERNATIONAL		
CLIENT CPC		PROJECT SRI LANKA		TITLE 11 METER BUOY HULL COMPOSITE
DIMENSION TOLERANCES DO NOT SCALE DRAWING		SCALE 1" = 1'-0"		
DRAWN JAY 9/1/86	CHECKED MAY 1/1/86	REVIEWED CBA 1/1/86	APPROVED A.A. 1/1/86	DWG. NO. 1191-000 SHEET 2 OF 3

8

7

6

5


4

3

2

1

REFERENCES		
NO.	TITLE	DRAWING NO.
1		
2		
3		
4		
5		
6		
REVISIONS		
NO.	DESCRIPTION	DATE
A	ISSUED FOR CONSTRUCTION	11/19/80
B	AS BUILT	11/19/80

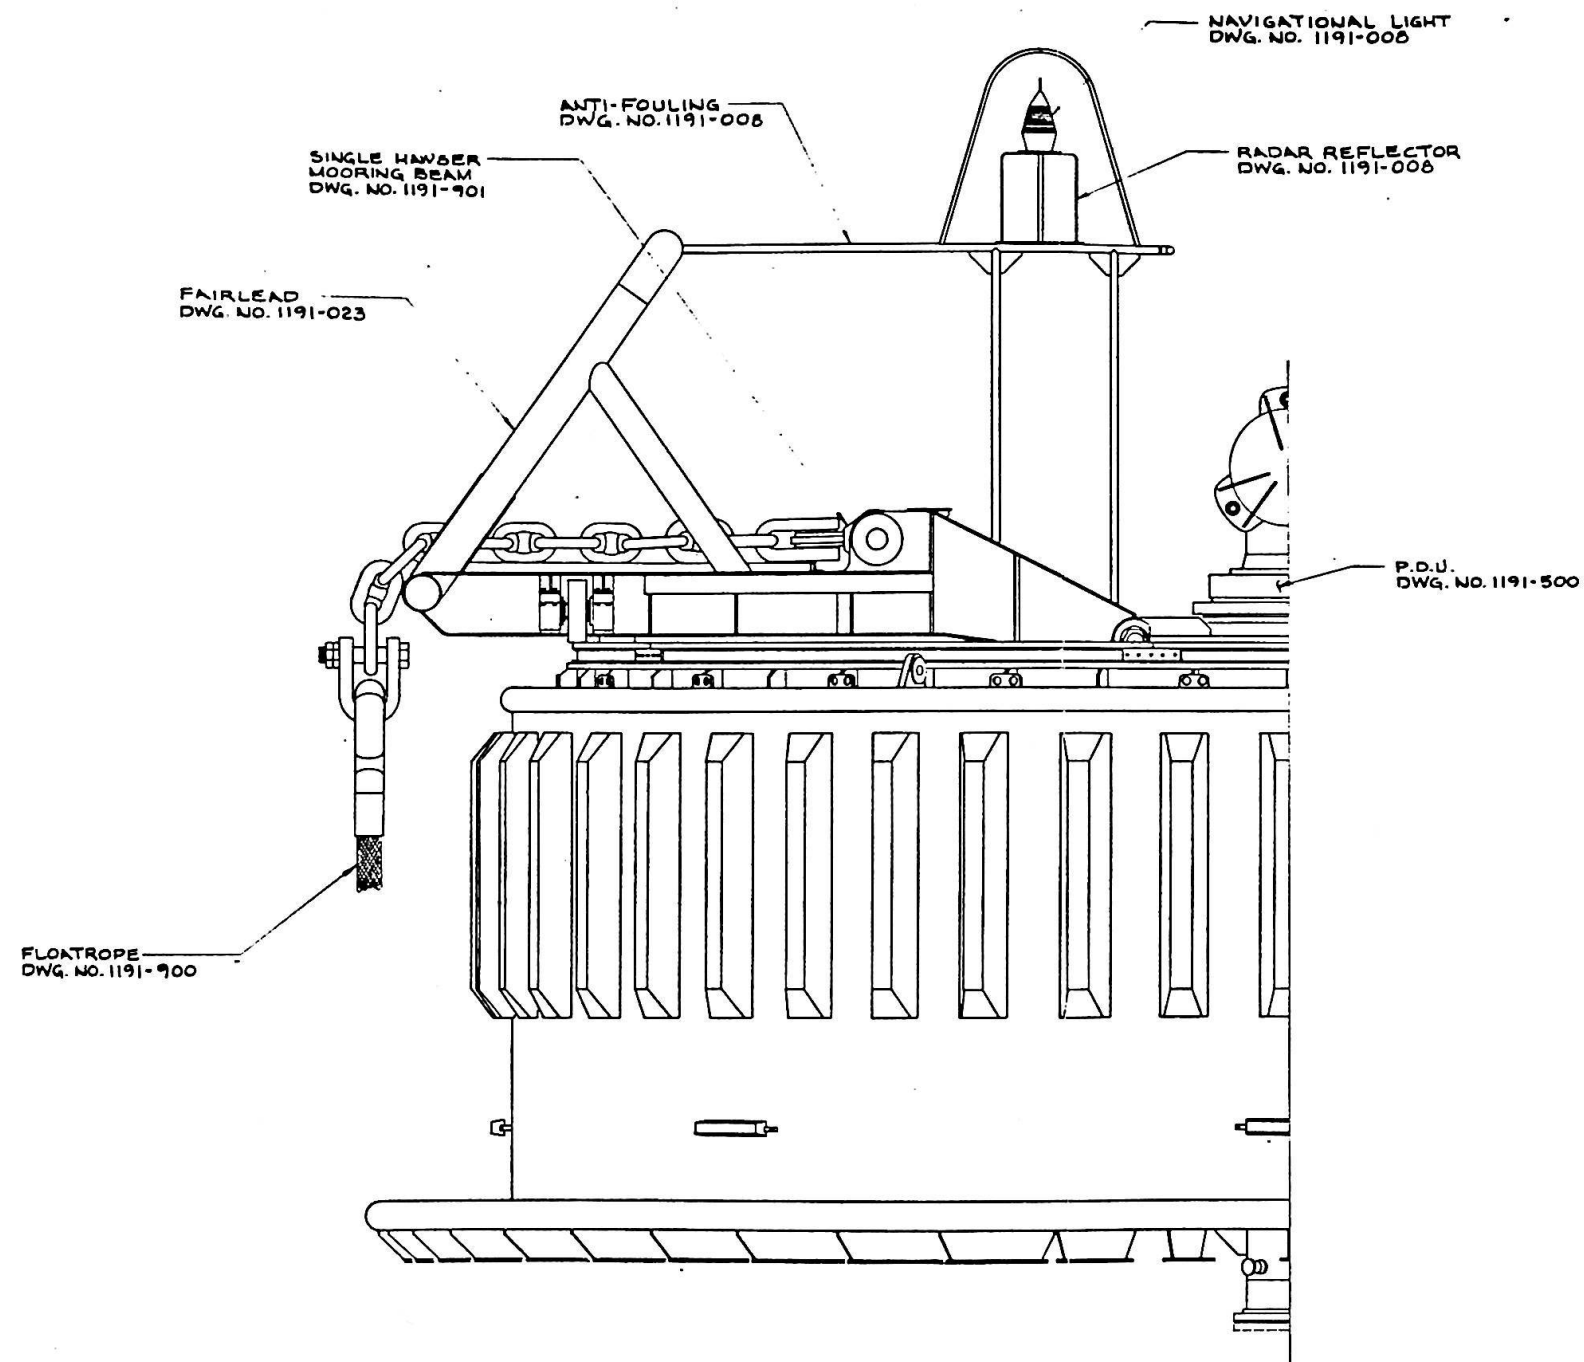

ELEVATION AT MOORING ARM

AS BUILT

ITEM	DESCRIPTION	SPEC	QTY	SHT
BILL OF MATERIAL				
<small>Information herein presented is confidential, proprietary information of IMODCO Marine Engineering Inc., a subsidiary of AMCA International Corporation. Any person obtaining this information is required to maintain its confidentiality, to agree not to disclose, use, reproduce or copy thereof, except as authorized by AMCA, and to return same on request.</small>				
<small>Copyright, IMODCO Marine Engineering Inc., 1988, ©</small>				
CLIENT CPC	PROJECT SRI LANKA	TITLE 11 METER BUOY HULL COMPOSITE		
DIMENSION TOLERANCES		SCALE 1"=1'-0"		
DO NOT SCALE DRAWING		DWG. NO. 1191-000		
DRAWN JAY 9/19/80	CHECKED JAY 11/19/80	REVIEWED JAY 11/19/80	APPROVED JAY 11/19/80	SHEET 3 OF 3
				REV A